

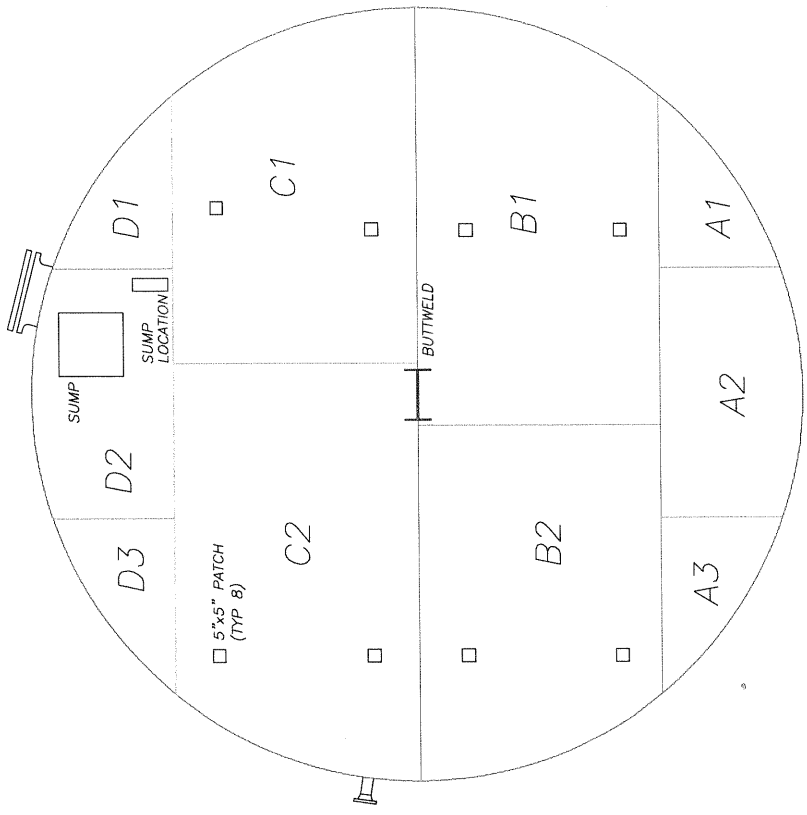


## **Section VI**

### **Drawings**

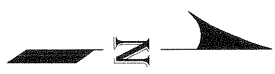


TANK SIZE: DIAMETER: NOMINAL = 25'-0"  
HEIGHT: NOMINAL = 18'-0"

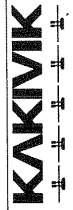


ASSET MANAGEMENT

ALASKA RAILROAD CORPORATION  
ANCHORAGE, ALASKA  
LOCOMOTIVE FUEL TANK


DATE: 5/12/06	DRAWN: CADDGuy Designs	SHEET: 1 OF 1	REV: 0
SCALE: NTS	DRAWING NO:	REV:	

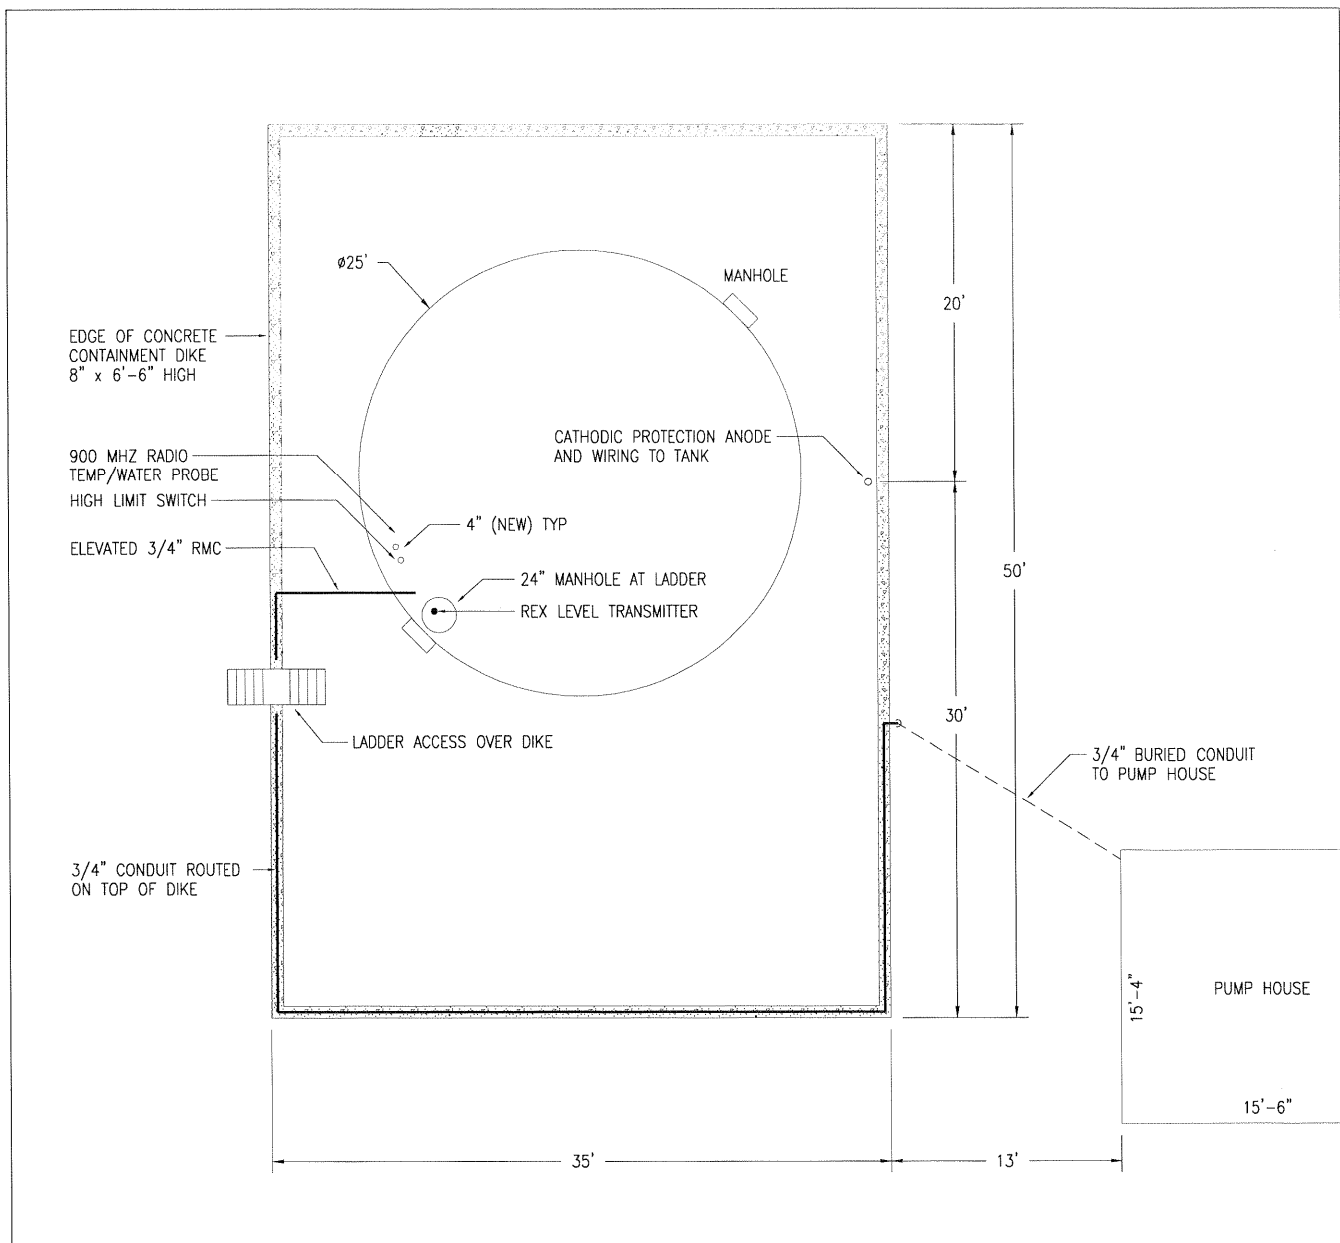

1 TANK REHABILITATION - AS-BUILT  
3/32"=1"

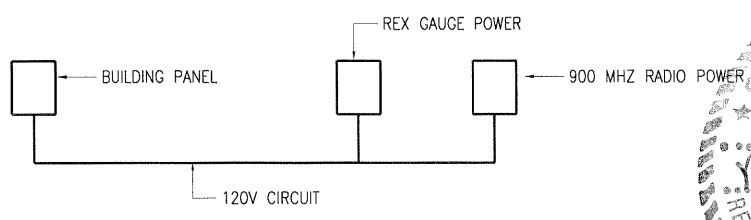

2 POWER ONE LINE DIAGRAM  
3/32"=1"

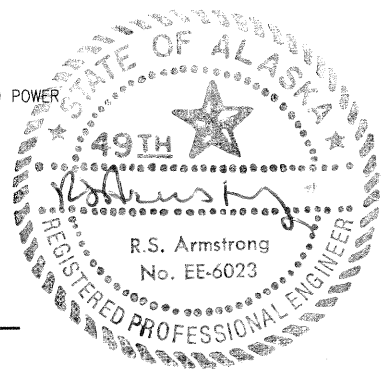

C:\Documents and Settings\vinetzel\Desktop\AK RR TANK REHAB.dwg Jul 19, 2006 - 8:47am

CHECKED  
RSA  
  
DATE  
06/22/06

**PRISM CONSTRUCTION**  
ALASKA RAILROAD TANK REHABILITATION  
AS-BUILT

**RSA**  
**Engineering, Inc.**  
MECHANICAL AND ELECTRICAL CONSULTING ENGINEERS  
2522 Arctic Boulevard, Suite 200  
Anchorage, AK 99503-2516  
Phone (907) 276-0521 Fax (907) 276-1751

SHEET  
**SK-M1**